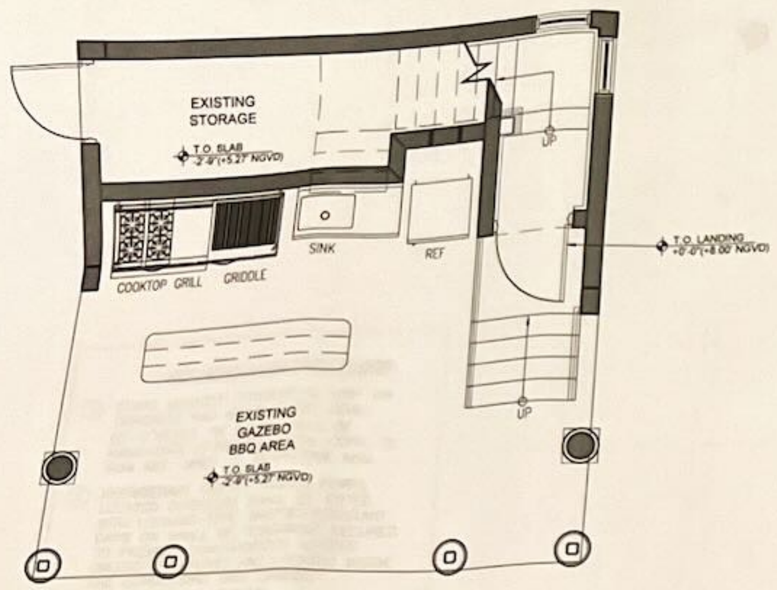

N 1 EXISTING GAZEBO GROUND FLOOR PLAN

Scale: 1/4" = 1'-0"

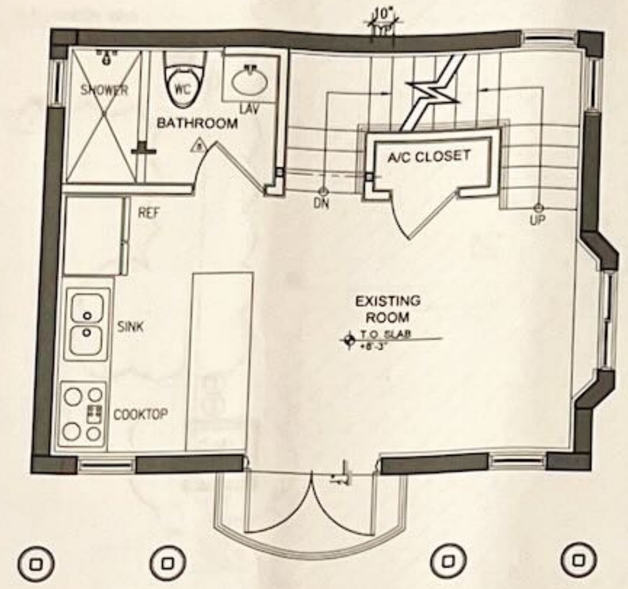

N 2 EXISTING GAZEBO LEVEL 2 FLOOR PLAN

Scale: 1/4" = 1'-0"

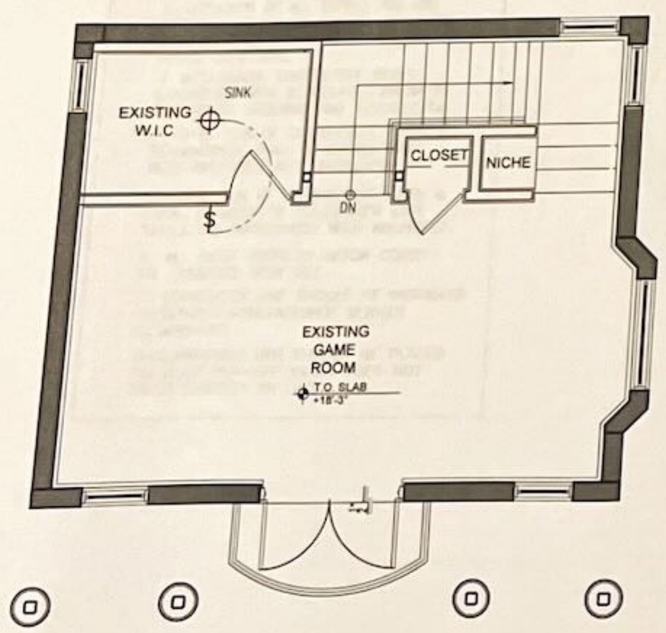

N 3 EXISTING GAZEBO LEVEL 3 FLOOR PLAN

Scale: 1/4" = 1'-0"

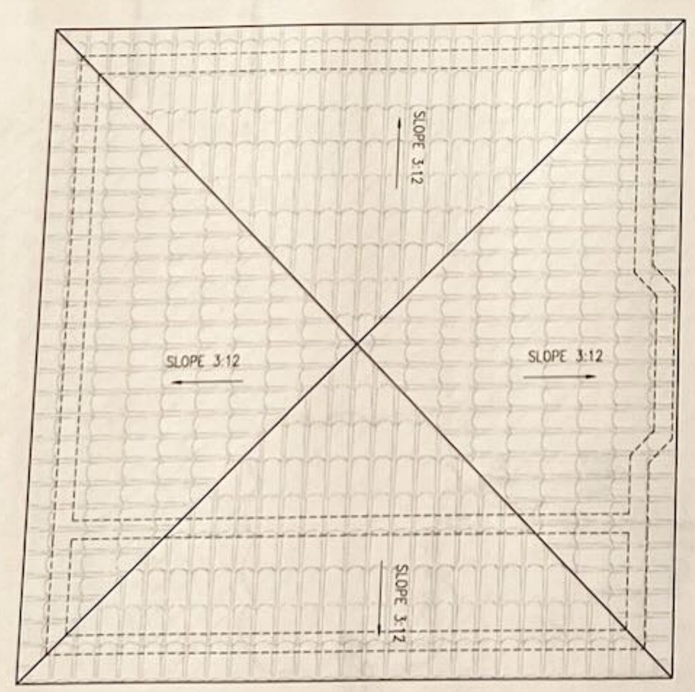

N 4 EXISTING GAZEBO ROOF PLAN

Scale: 1/4" = 1'-0"

TAG ARCHITECTURE

TAG ARCHITECTURE LLC
PO Box 402332
Miami Beach, FL
305 866 8792
305 318 0670
jgav.arch@gmail.com

Copyright Statement:
All drawings and written material appearing herein are the original and unpublished work of TAG Architecture LLC. and may not be duplicated, used, or disclosed without the express written consent of TAG Architecture LLC. © 2020

NOV 26 2024

STATE OF FLORIDA JEROME GAVCOVICH AR 0016294 REGISTERED ARCHITECT

JEROME GAVCOVICH
AR #0016294

CLIENT

SHEET TITLE: EXISTING GAZEBO PLANS

PROJECT: IGLESIAS RESIDENCE
370 ATLANTIC AVENUE

PROJECT NO. : 20-237
DRAWN BY: MD
CHECKED BY: JG
DATE: 03-17-20

REV.	DATE	DESCRIPTION
2	08-26-24	GAZEBO AS-BUILT

SHEET A-12